 
 

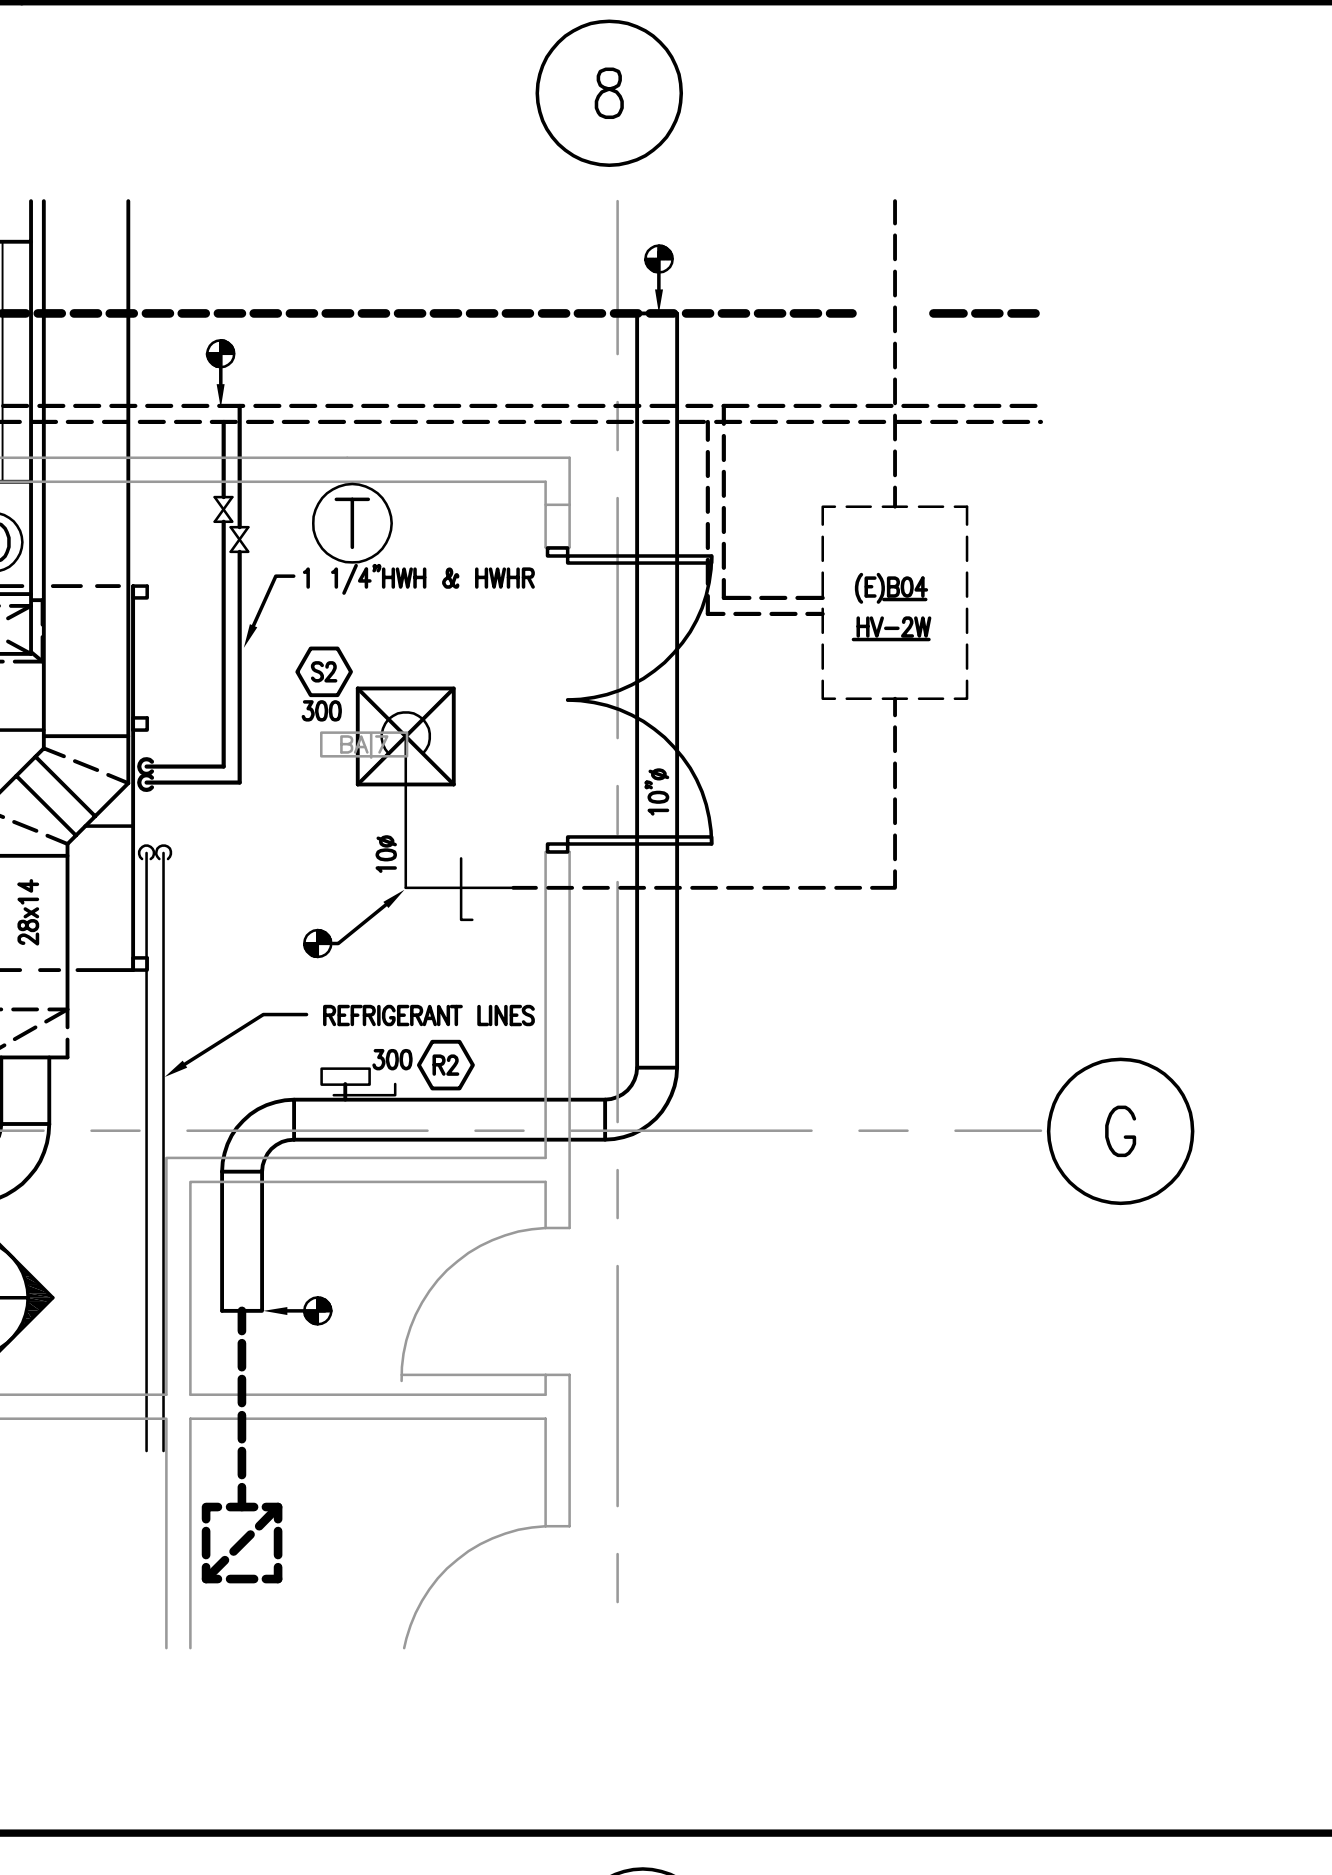
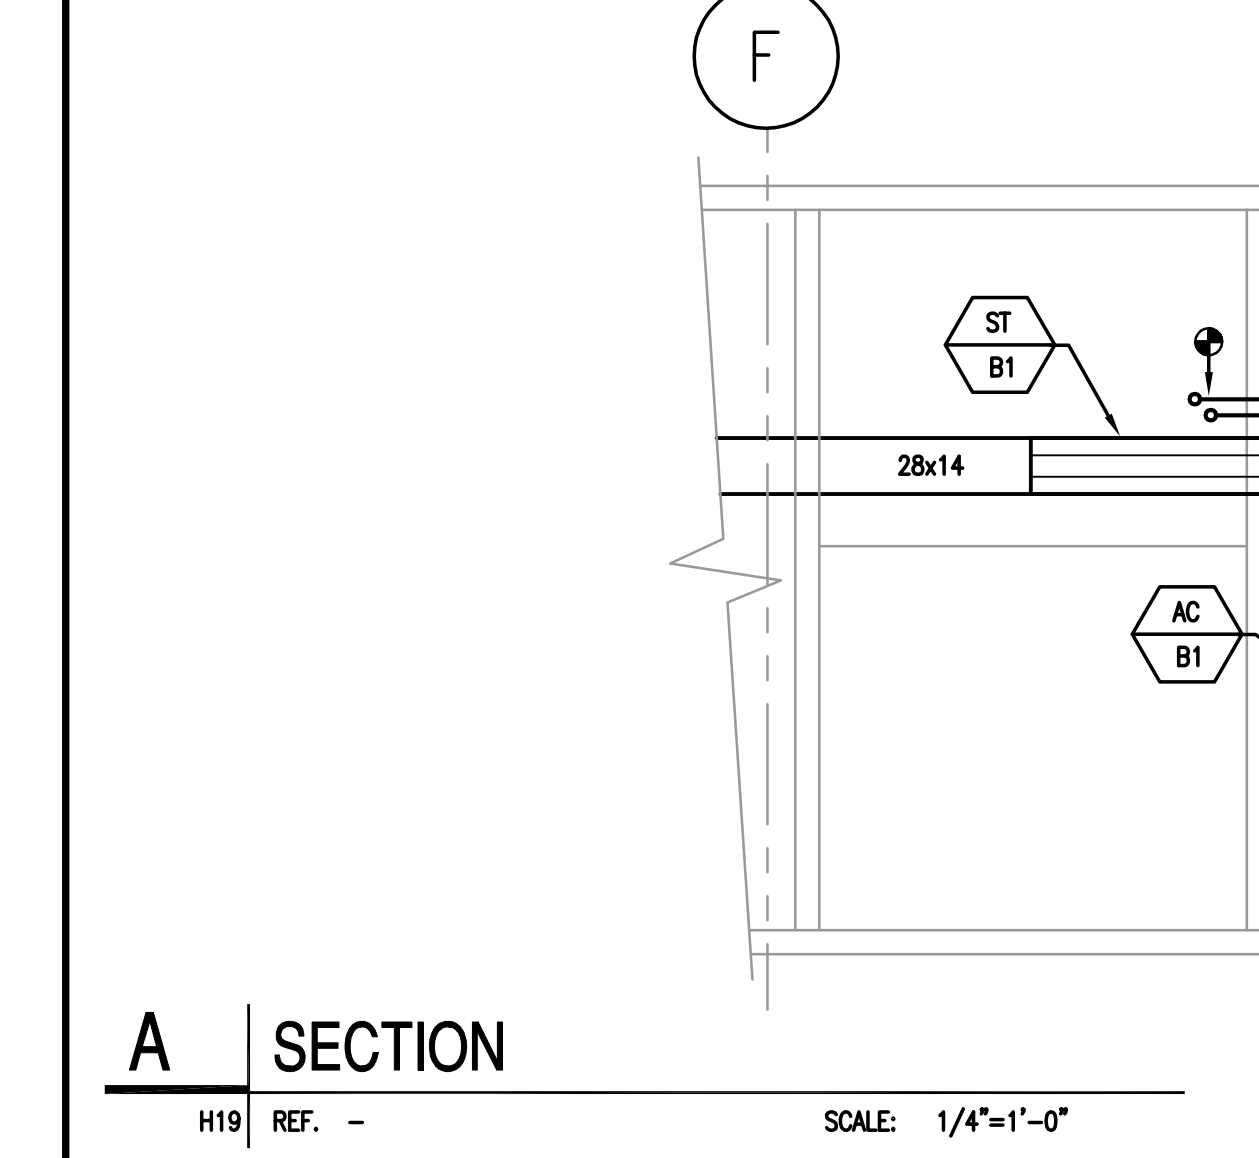
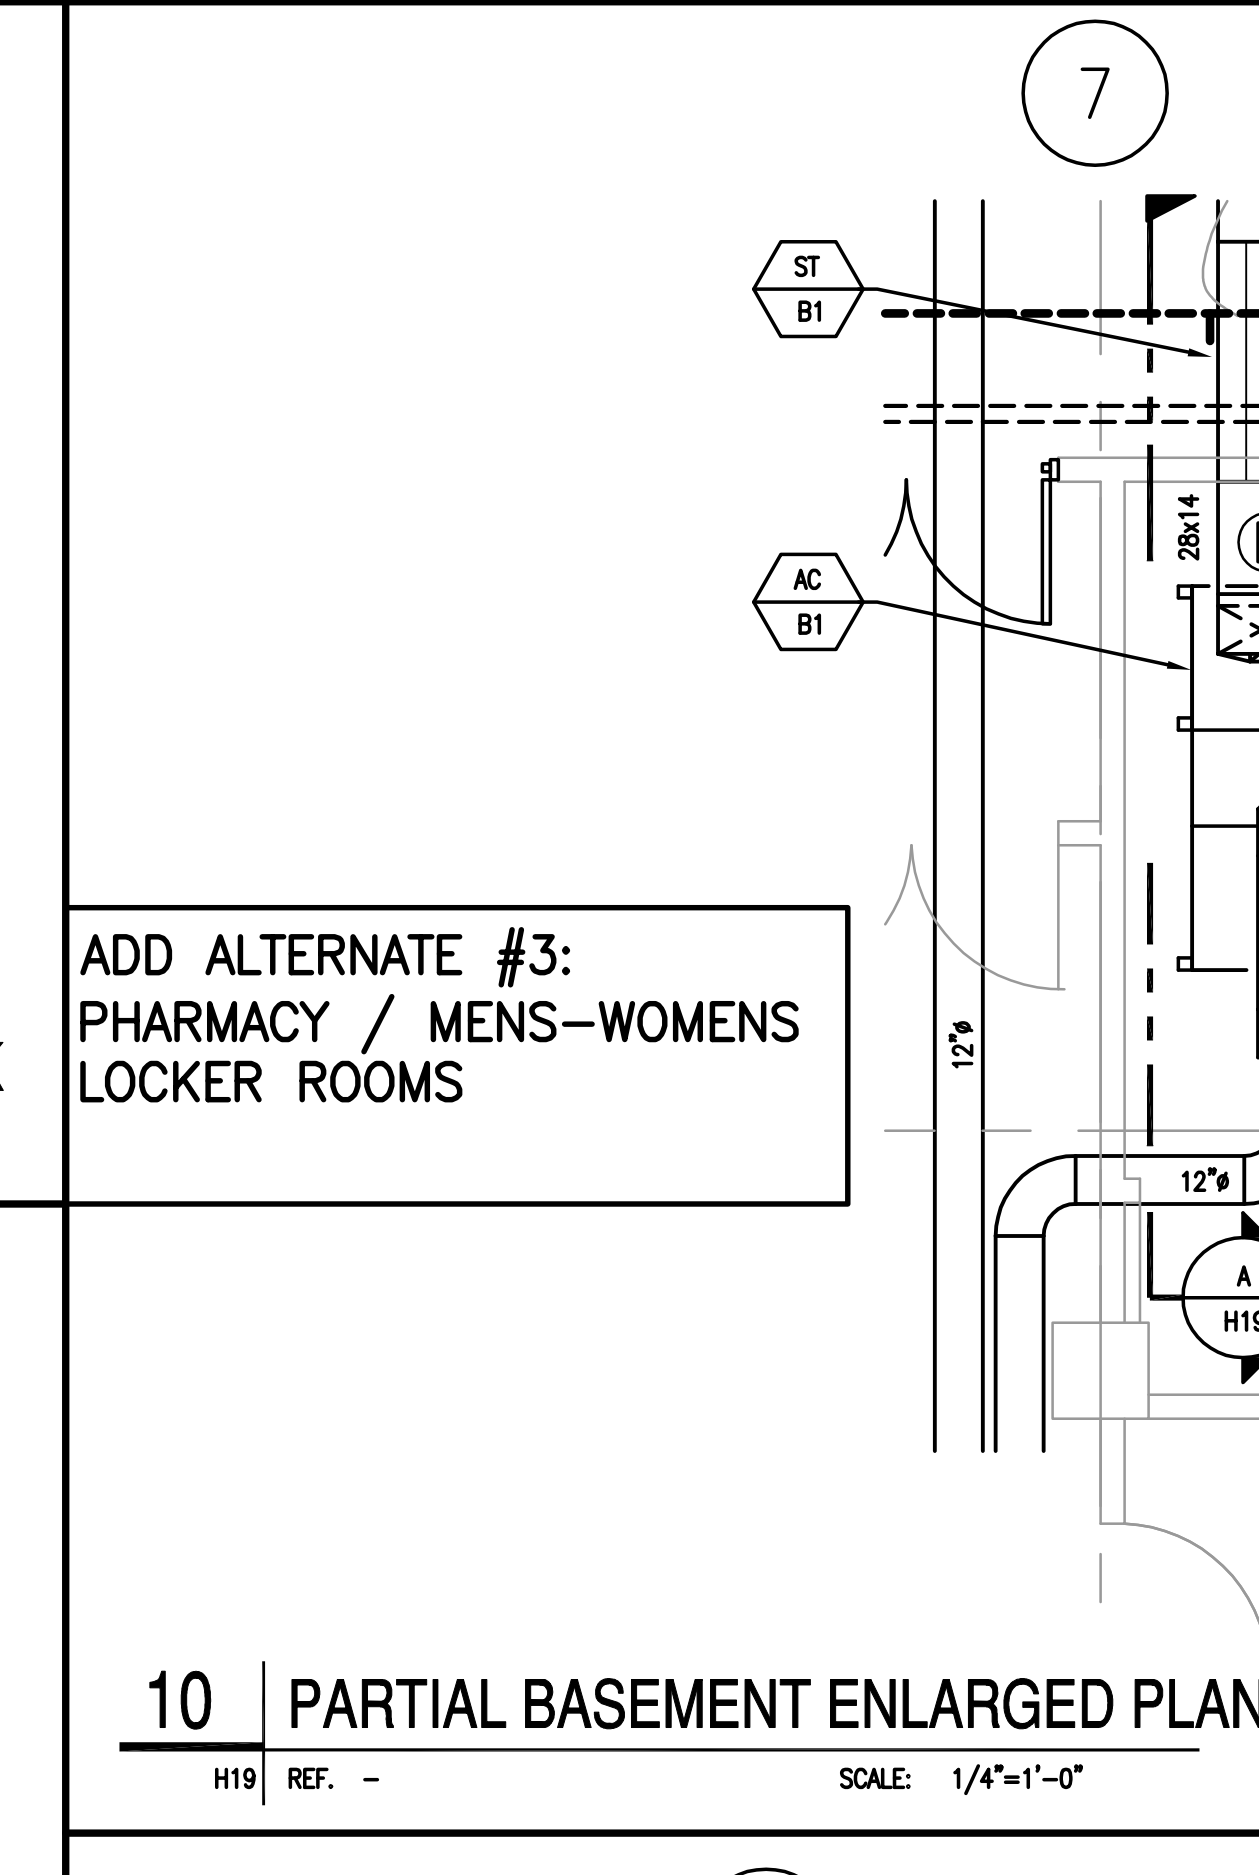
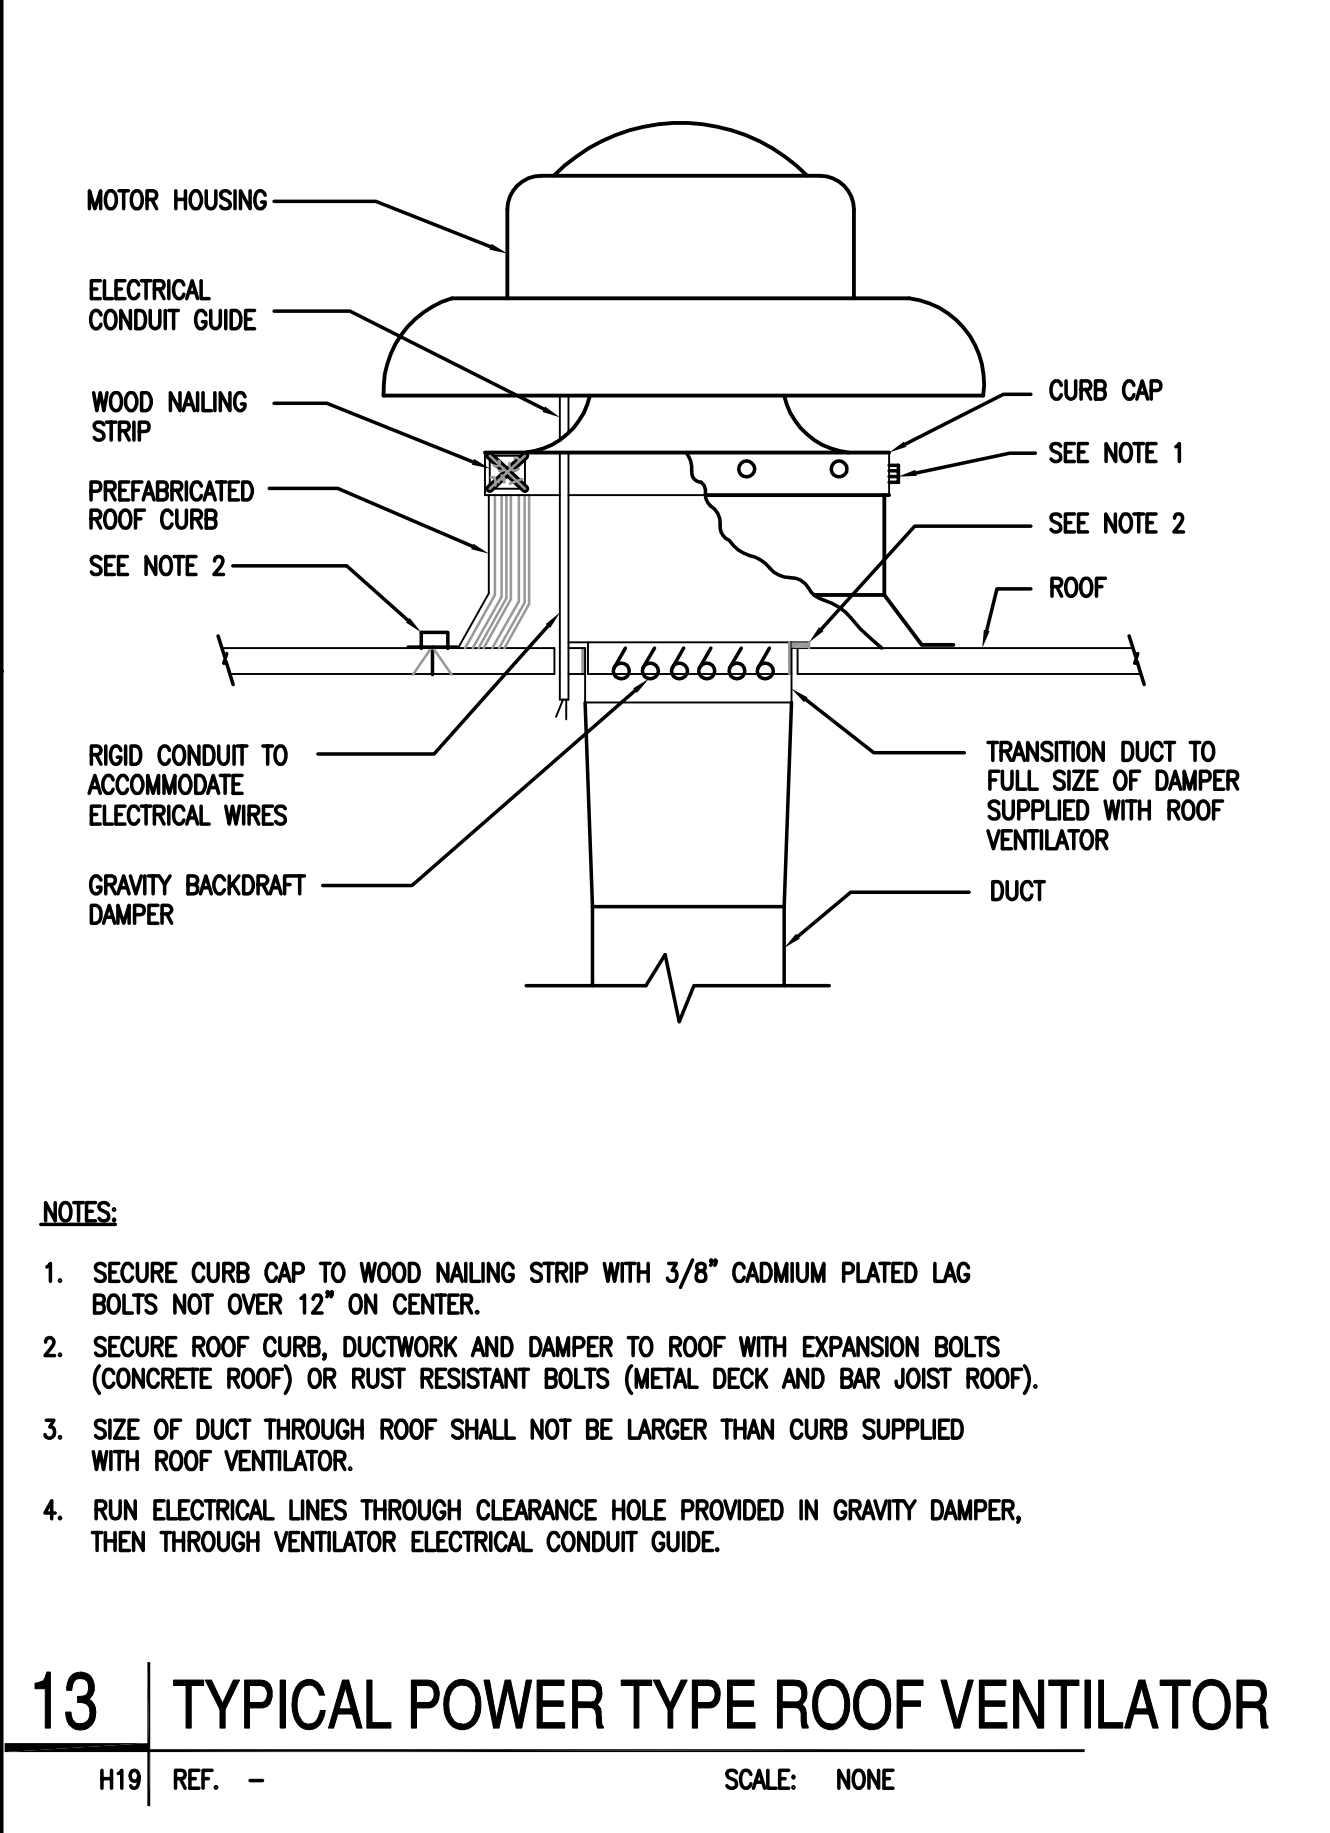
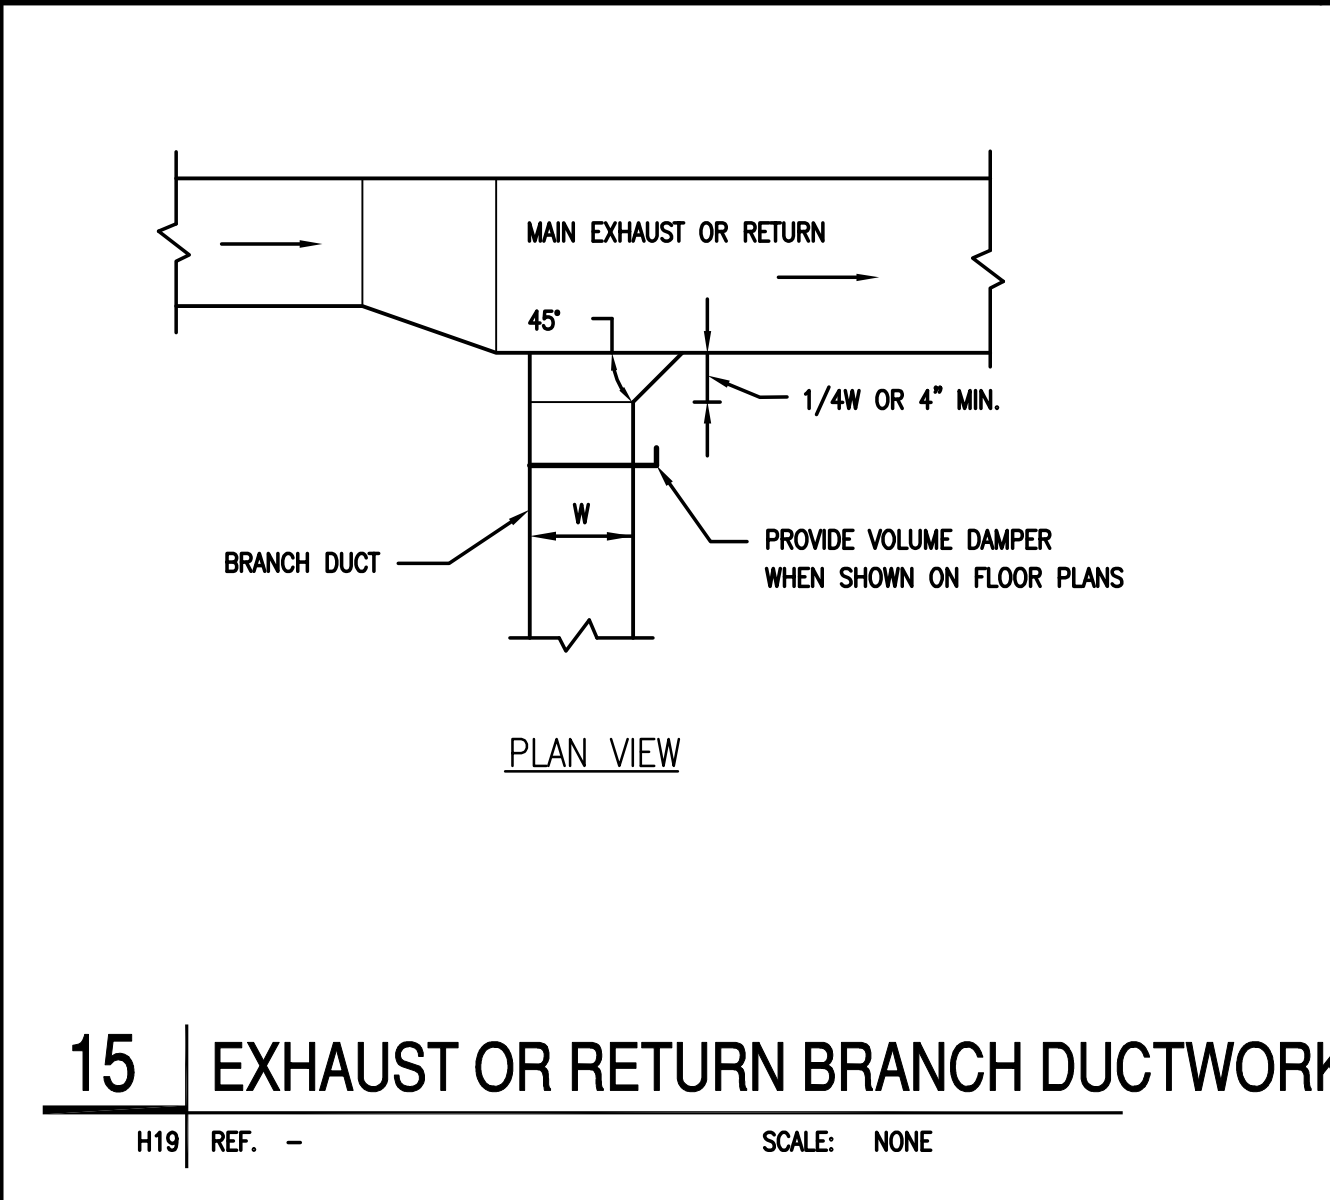


NOTES:

1. FOR ABBREVIATIONS, LEGEND, AND GENERAL NOTES SEE H1

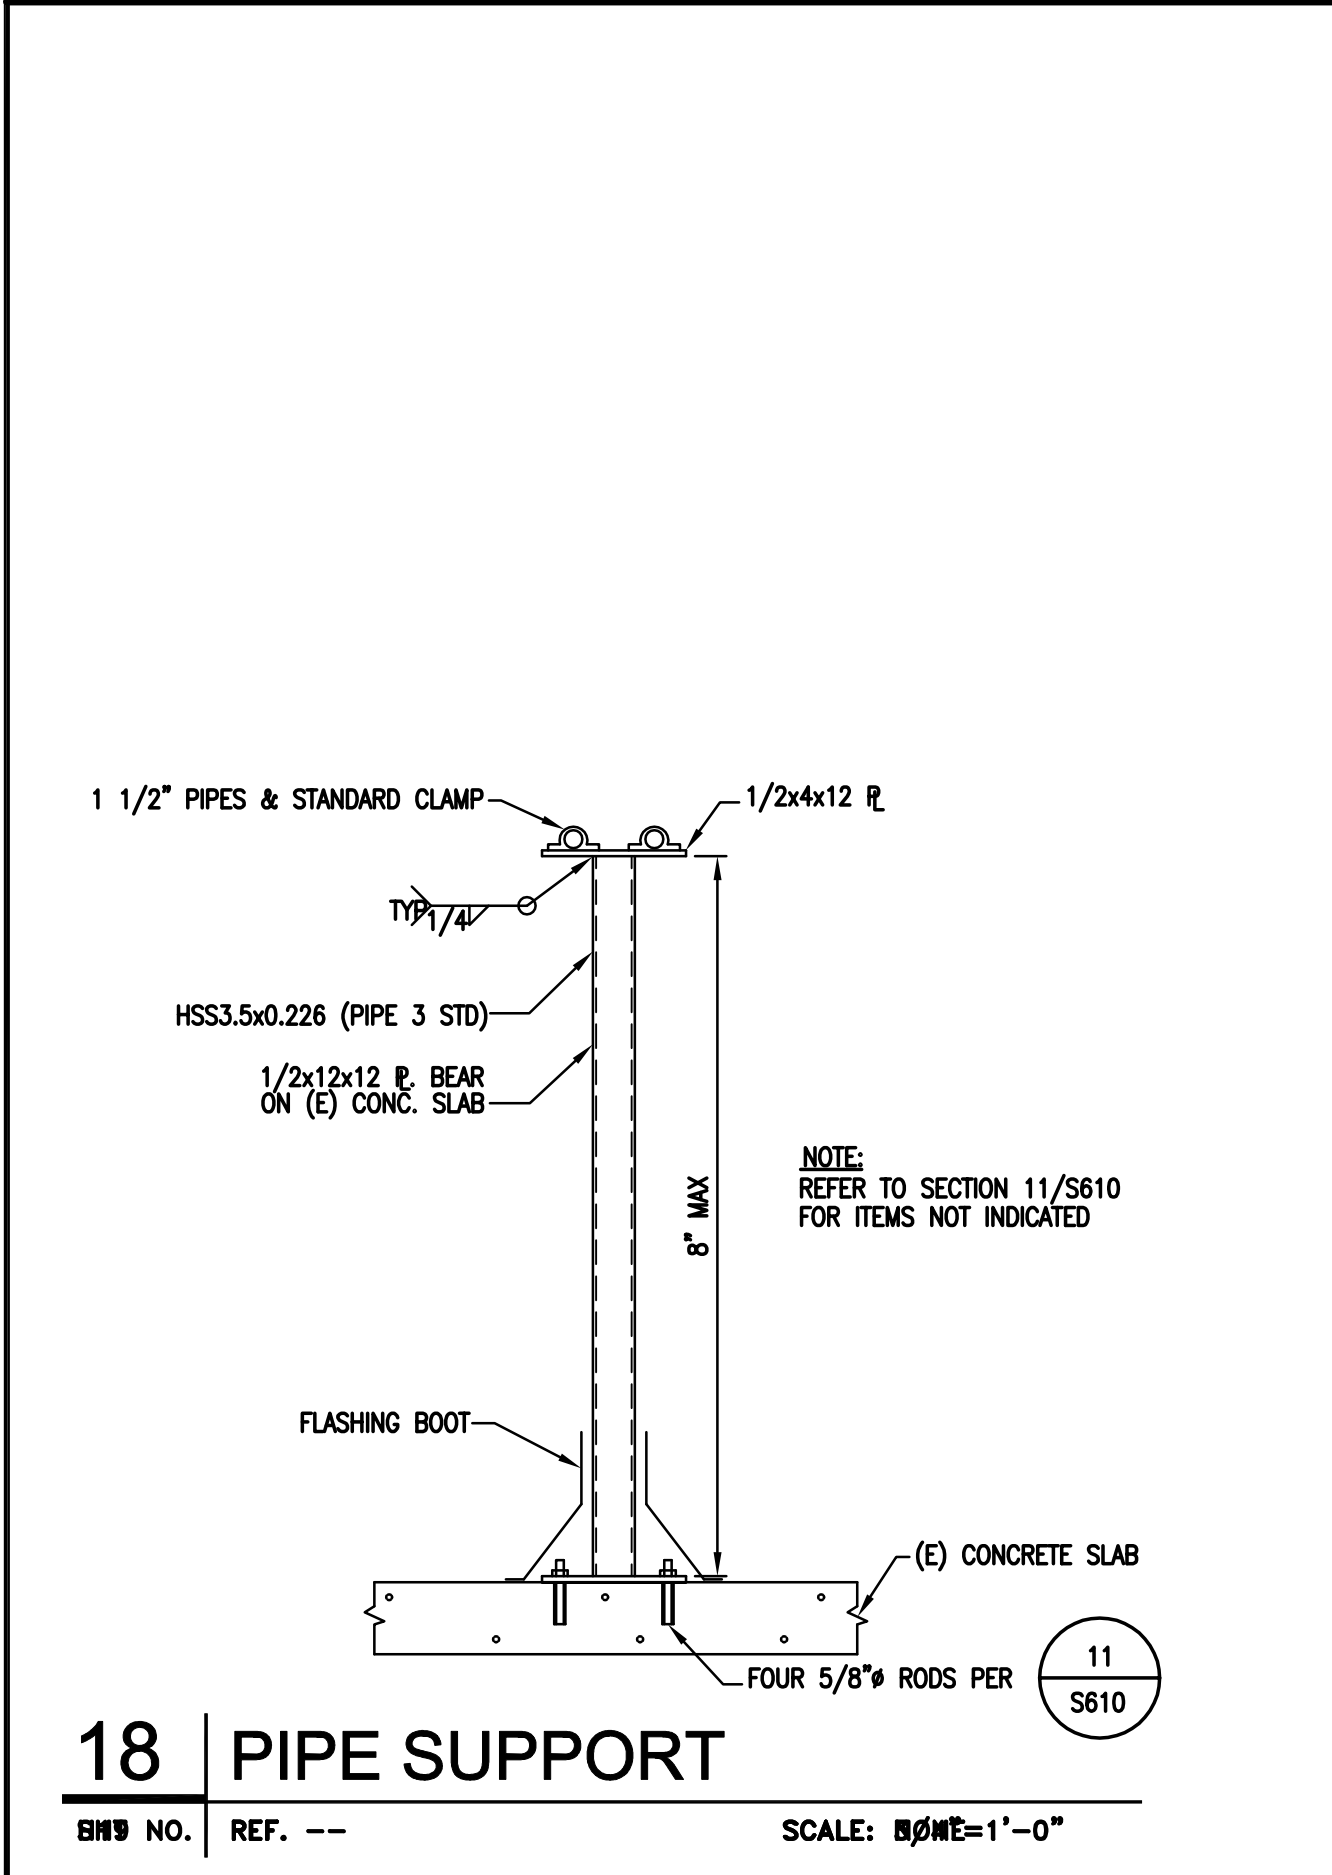

RECORD DRAWINGS	09/04/09
Revisions:	Phase Date

CONSULTANTS:	
--------------	--

FULLY SPRINKLERED	
-------------------	--

ARCHITECTS/ENGINEERS:	
HGA	DMJMH+N
Degenkolb	

Drawing Title	MECHANICAL DETAILS
Approved: Project Director, Western Team	

Project Title	VA SEISMIC CORRECTIONS BUILDING 203
Location	San Francisco, CA
Date	AUGUST 09, 2005
Checked	NP
Drawn	JSR

Project Number	662-401
Building Number	203
Drawing Number	H19
Dwg. -- of	

